

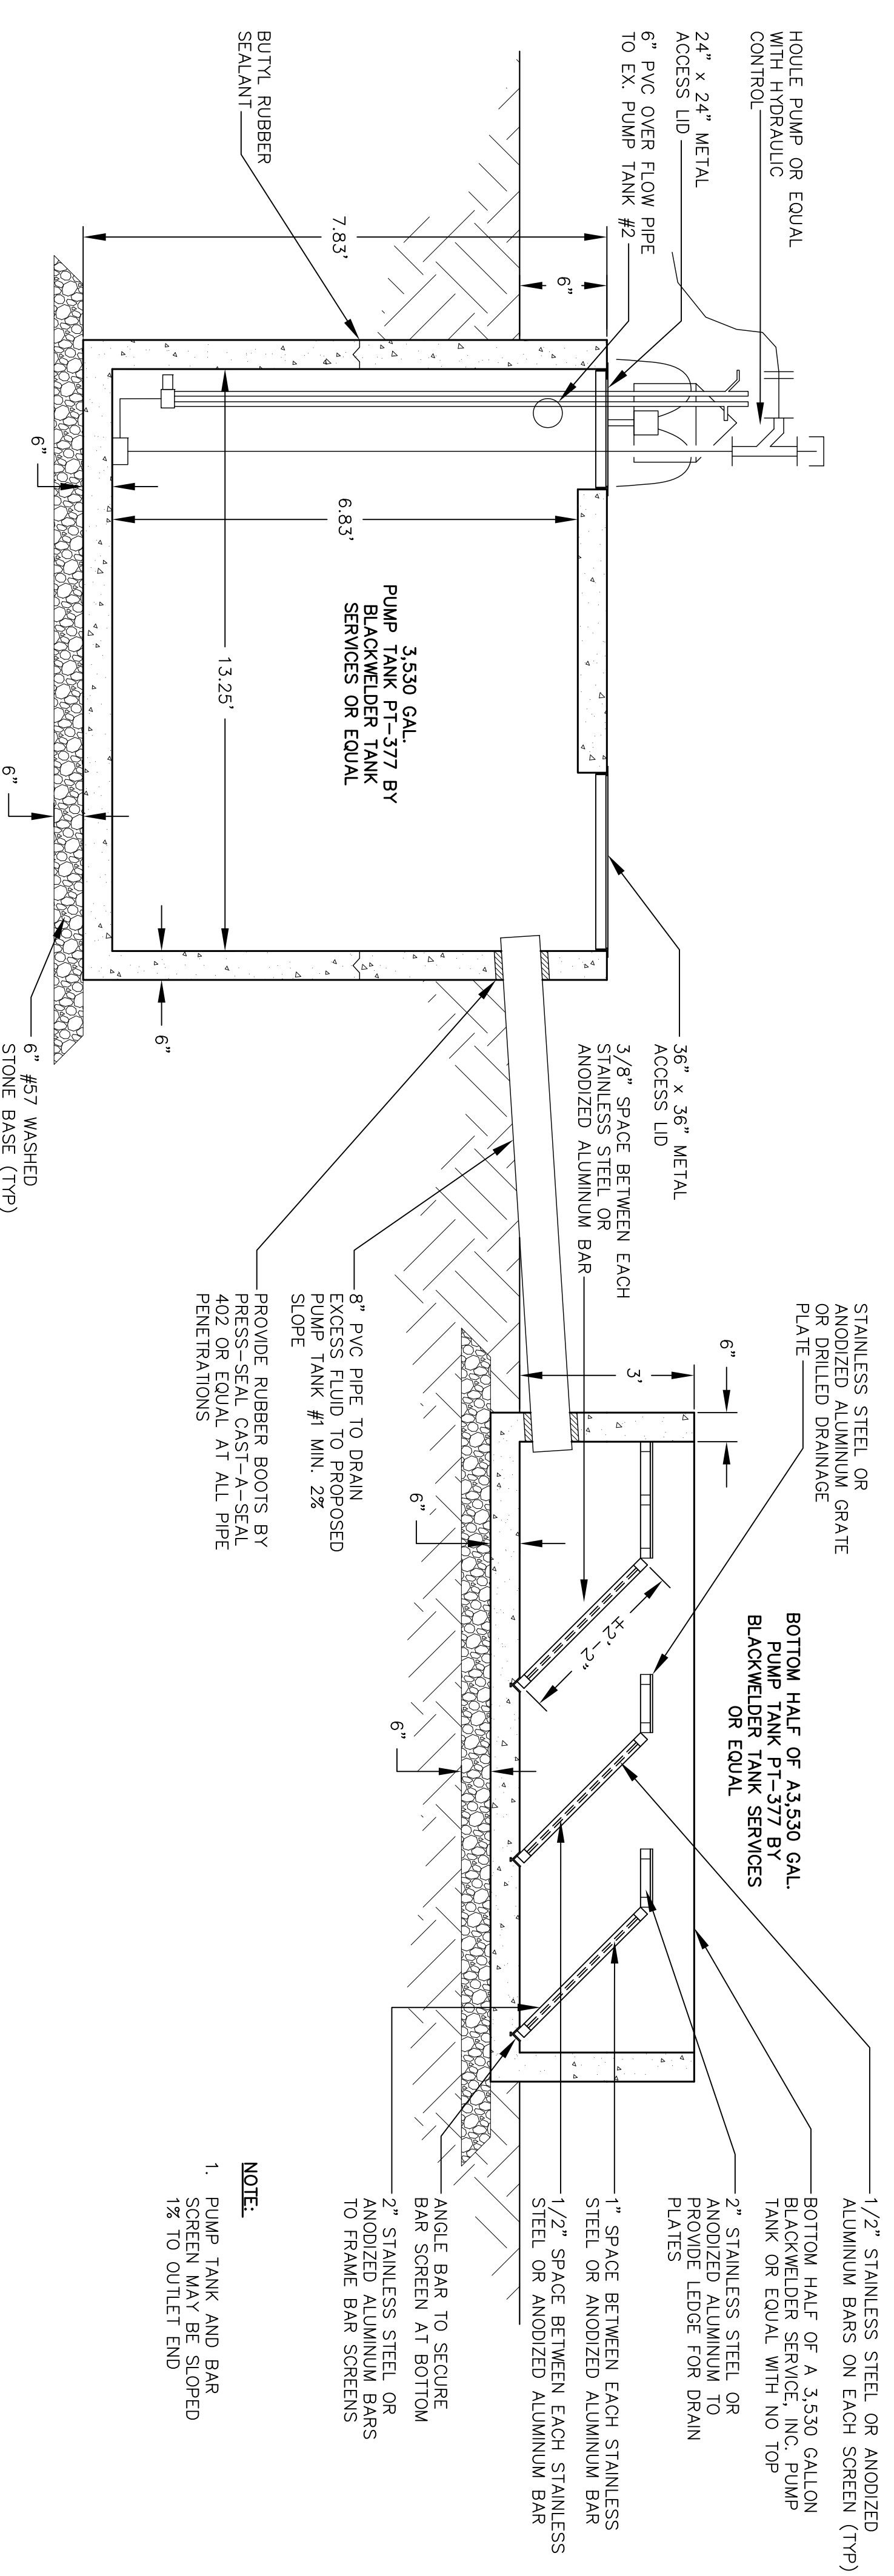


NOTES:


1. SEE C-101 FOR ALL GENERAL NOTES.

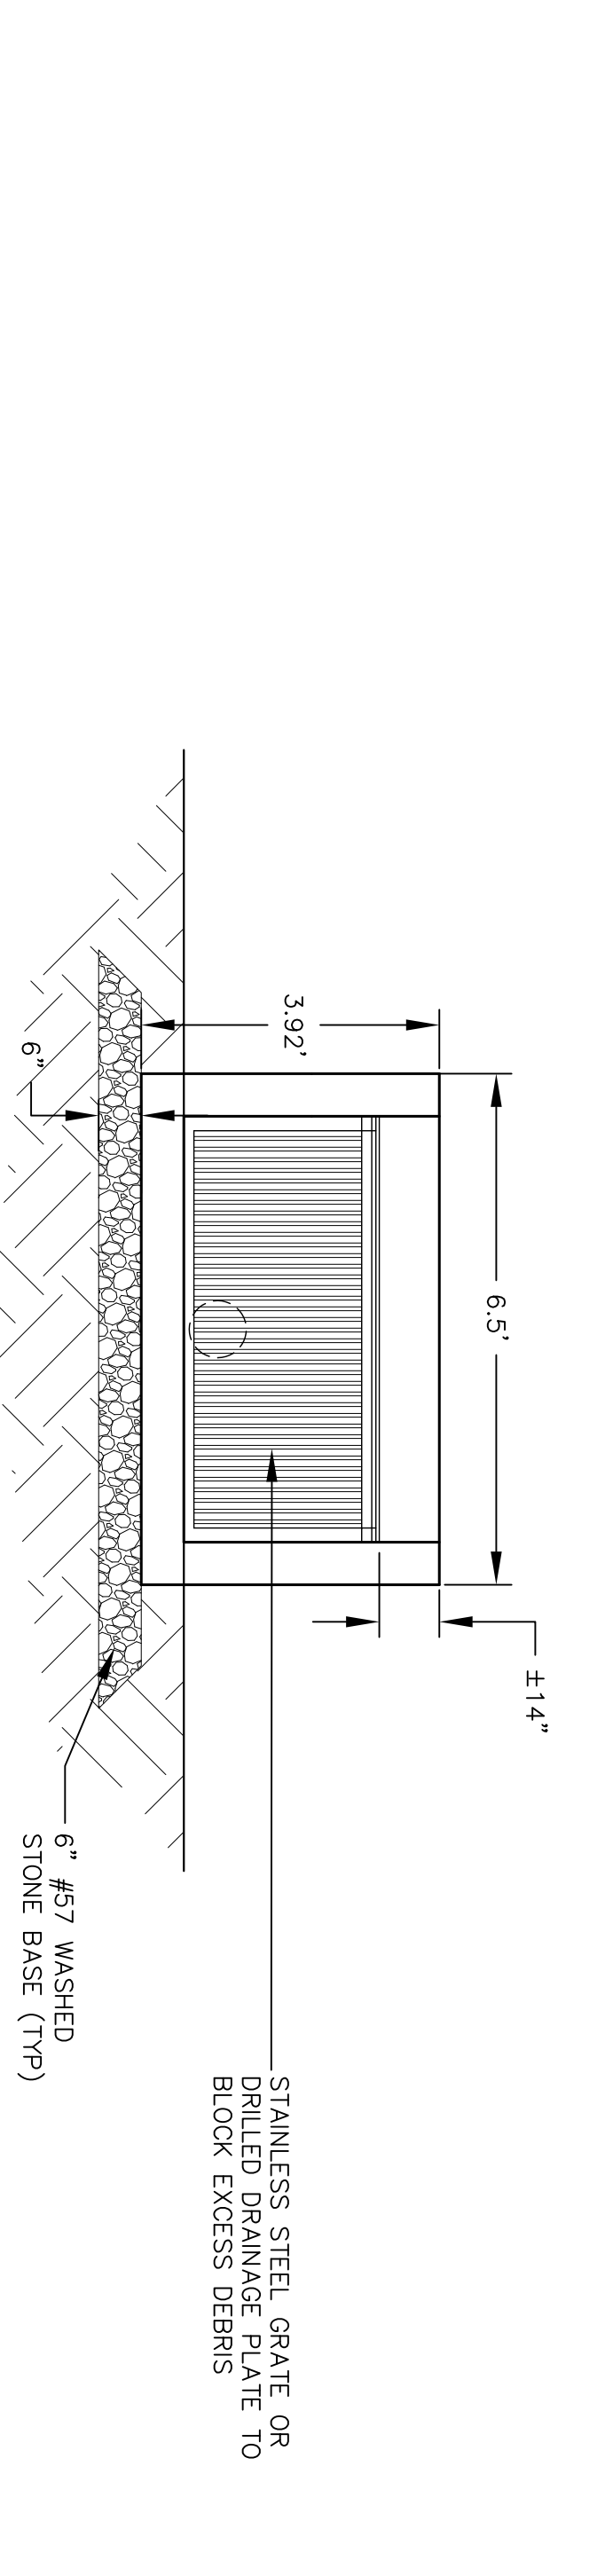

1 PUMP TANK #1 AND BAR SCREEN DETAIL
D-102 / NOT TO SCALE

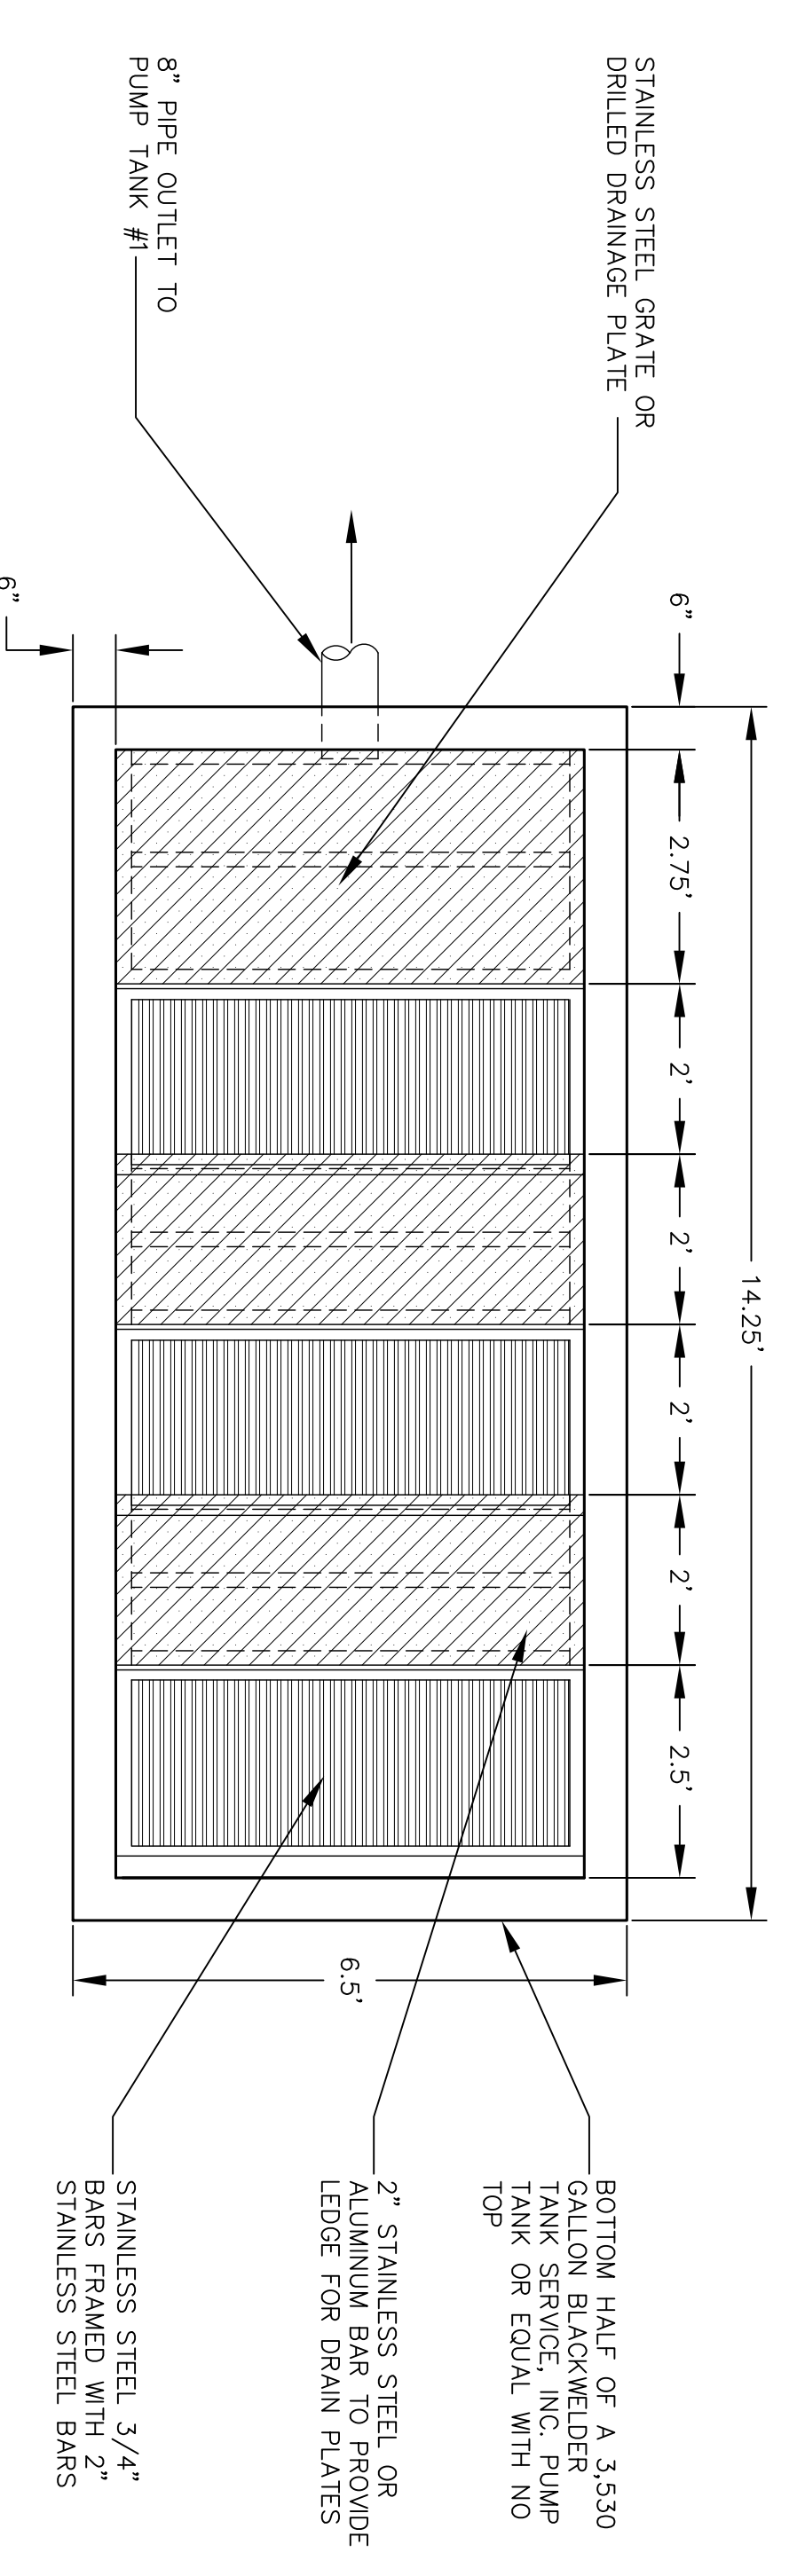

2 DEWATERING BOX CONCRETE PAD DETAIL
D-102 / NOT TO SCALE

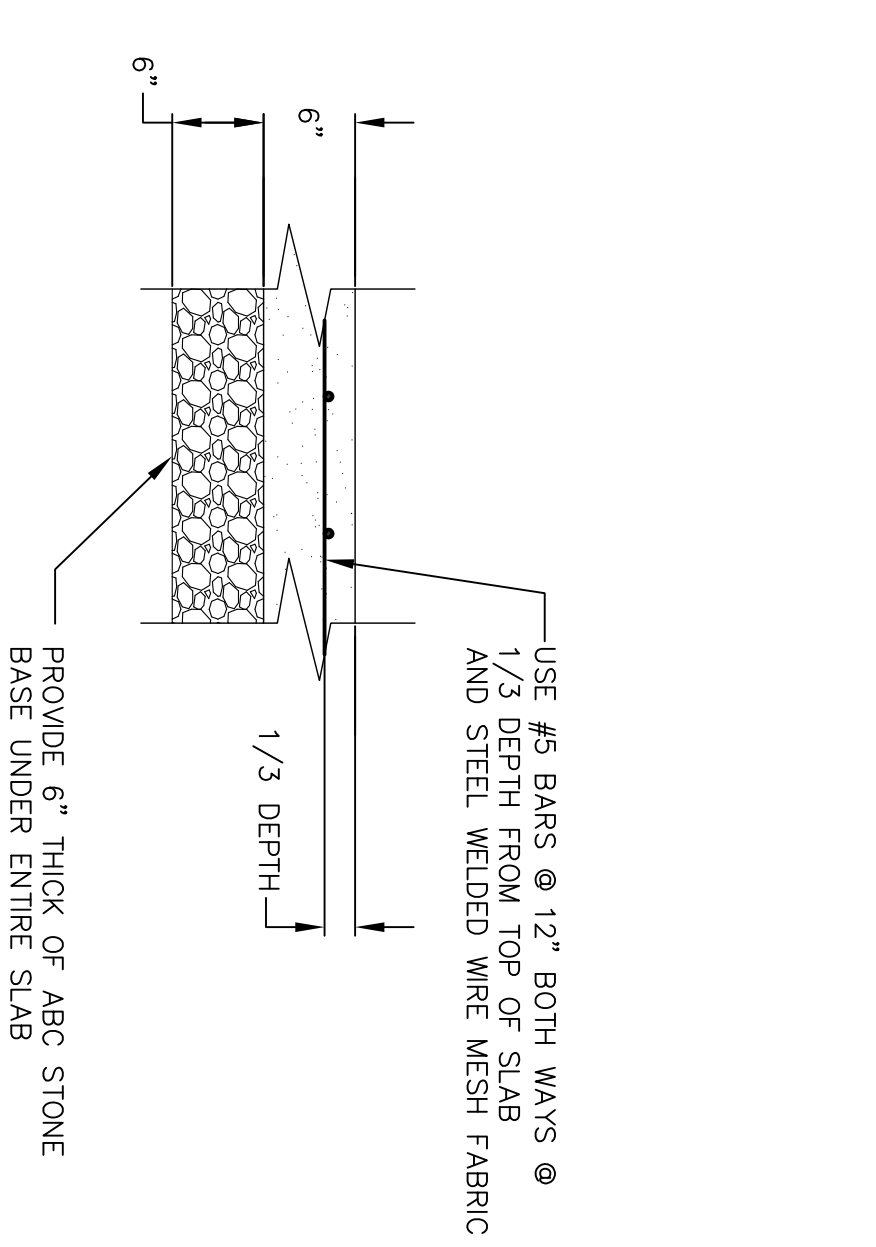

4 TYPICAL CONCRETE PAD DETAIL
D-102 / NOT TO SCALE

3 BAR SCREEN DETAIL
D-102 / NOT TO SCALE

THESE RECORD DRAWINGS HAVE BEEN PREPARED BASED UPON INFORMATION FURNISHED BY OTHERS. WHILE THIS DRAWING IS THE PROPERTY OF MACCONNELL & ASSOCIATES, P.C., THE USER OF THIS DRAWING SHALL BE RESPONSIBLE FOR THE ACCURACY OF THIS RECORD. THE USER SHALL BE RESPONSIBLE FOR OBTAINING ALL NECESSARY PERMITS AND FOR THE RESULTS OF ANY FIELD VERIFICATION OF ITS ACCURACY BEFORE ANY CONSTRUCTION.

RECORD DRAWING
OCTOBER 31, 2008

NO.	DATE	DESCRIPTION
1	05/30/07	REV PER SOLID WASTE SECTION
2	10/31/08	RECORD DRAWING

PROJECT MANAGER:	ZLF
DRAWN BY:	ZLF
CHECKED BY:	ZLF
DATE:	APRIL 11, 2007

MacCONNELL & Associates, P. C.
 909 AVIATION PARKWAY, SUITE 1400
 MORRISVILLE, NORTH CAROLINA 27560
 P. O. BOX 728
 TEL: (919) 467-1239 FAX: (919) 319-6570

Craven AG Services, Inc.
 DEWATERING BOX
 CRAVEN COUNTY, NC

PROJECT NUMBER	A36001.00
DRAWING NUMBER	D-102
DETAIL SHEET 2	